


# AVAILABLE SPACE

Suite: 1500 Floor: 15 Footage: 21,254 Availability: Now

Comments: As-built plan



50 WEST

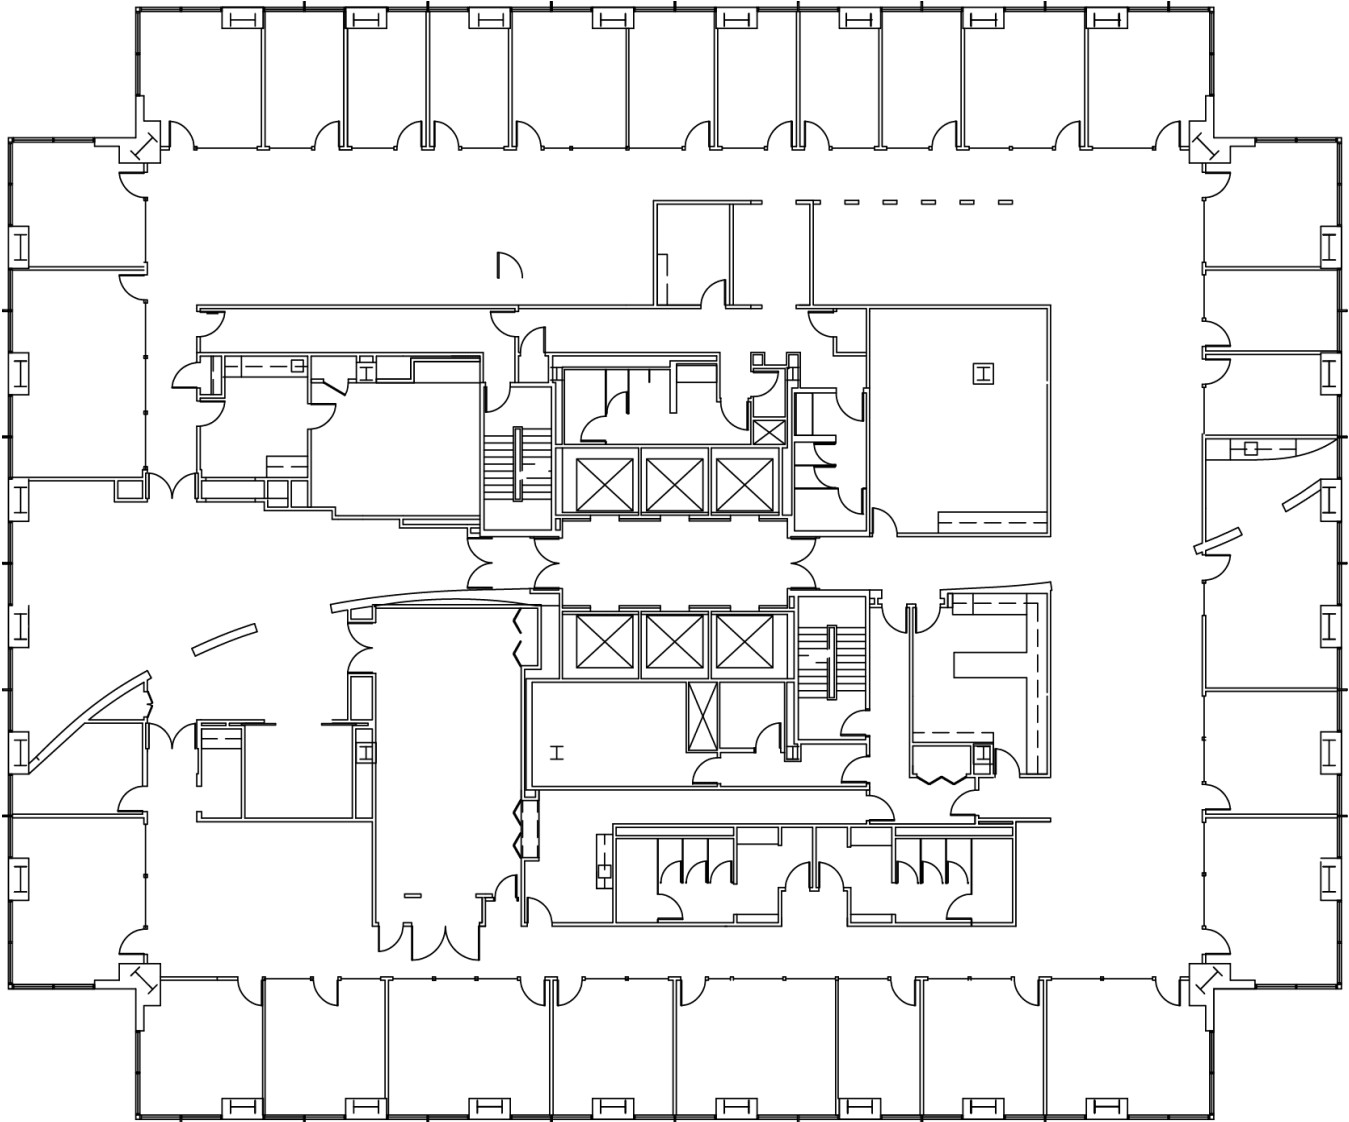

For more information, please contact the leasing team:

[www.50westsanfernando.com](http://www.50westsanfernando.com)

Steve Horton  
Vice Chairman  
+1 408 615 3412  
[steve.horton@cushwake.com](mailto:steve.horton@cushwake.com)  
Lic. # 01127340

Jeff Cushman  
Executive Managing Director  
+1 408 572 4122  
[jeff.cushman@cushwake.com](mailto:jeff.cushman@cushwake.com)  
Lic. # 01308295



Brandon Bain  
Executive Managing Director  
+1 408 615 3416  
[brandon.bain@cushwake.com](mailto:brandon.bain@cushwake.com)  
Lic. # 01308375

Scott Dever  
Director  
+1 408 572 4162  
[scott.dever@cushwake.com](mailto:scott.dever@cushwake.com)  
Lic. # 01890552

 DIVCOWEST

ROCKPOINT  
GROUP